




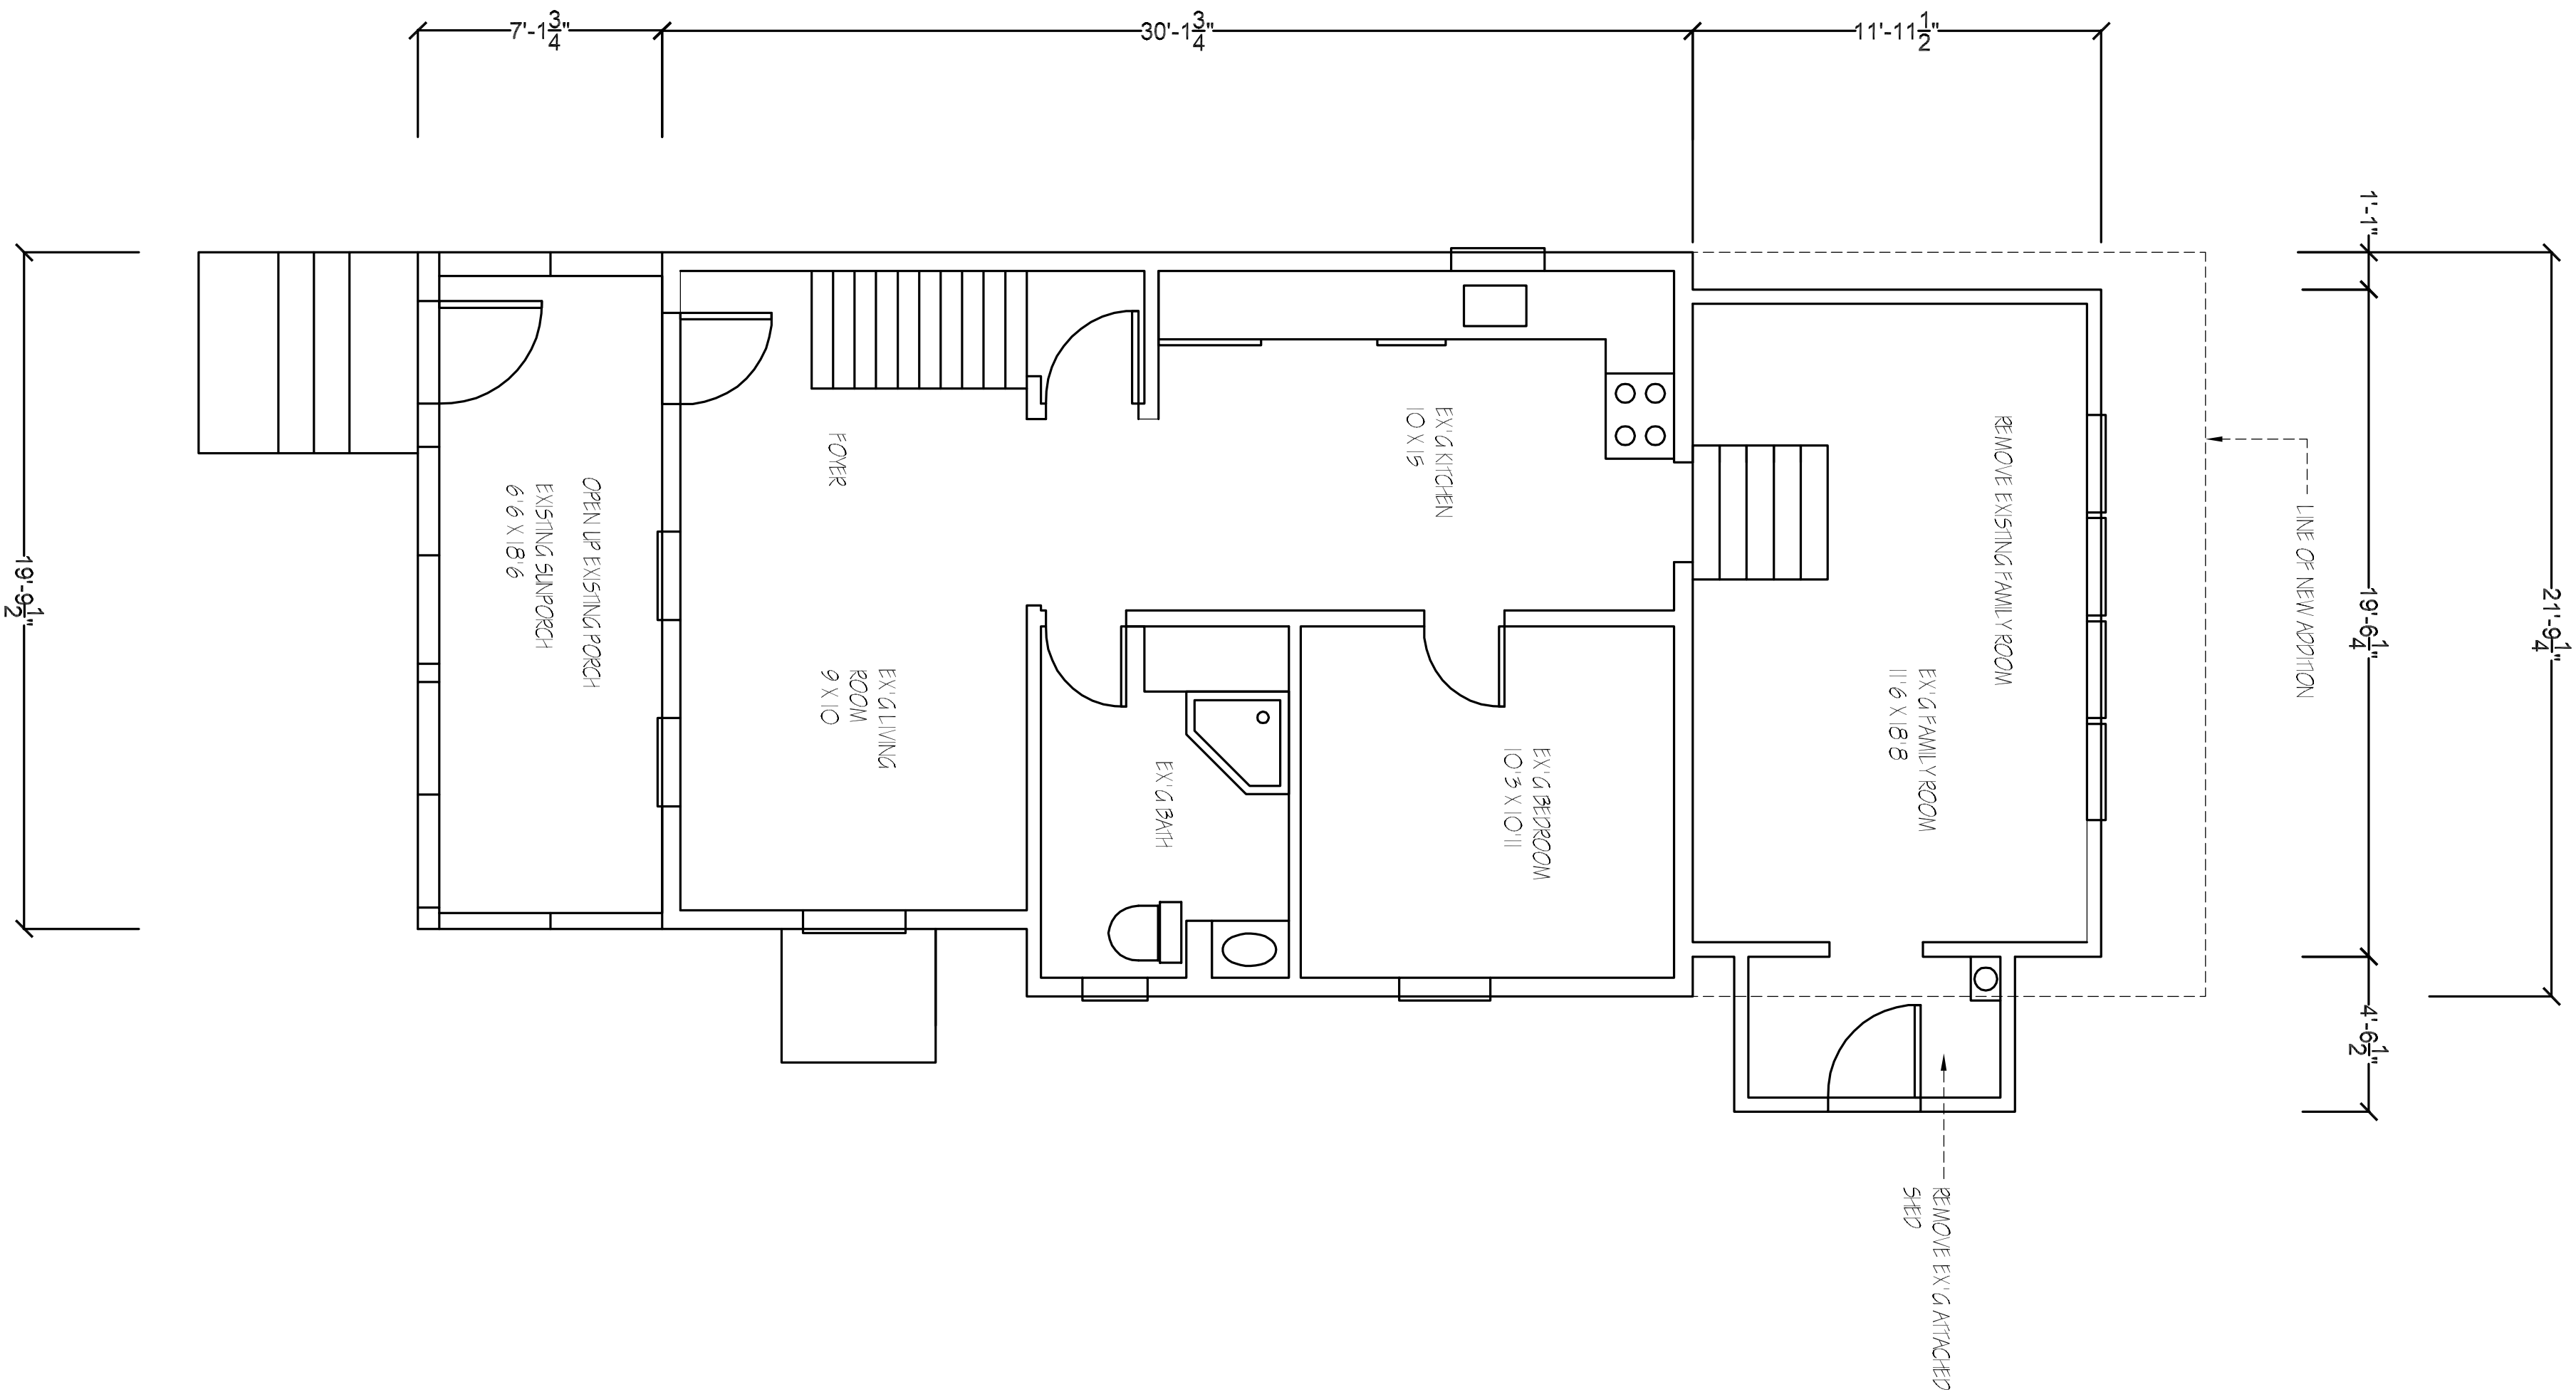

1
5
EXISTING FIRST FLOOR
SCALE 1/4" = 1'-0"

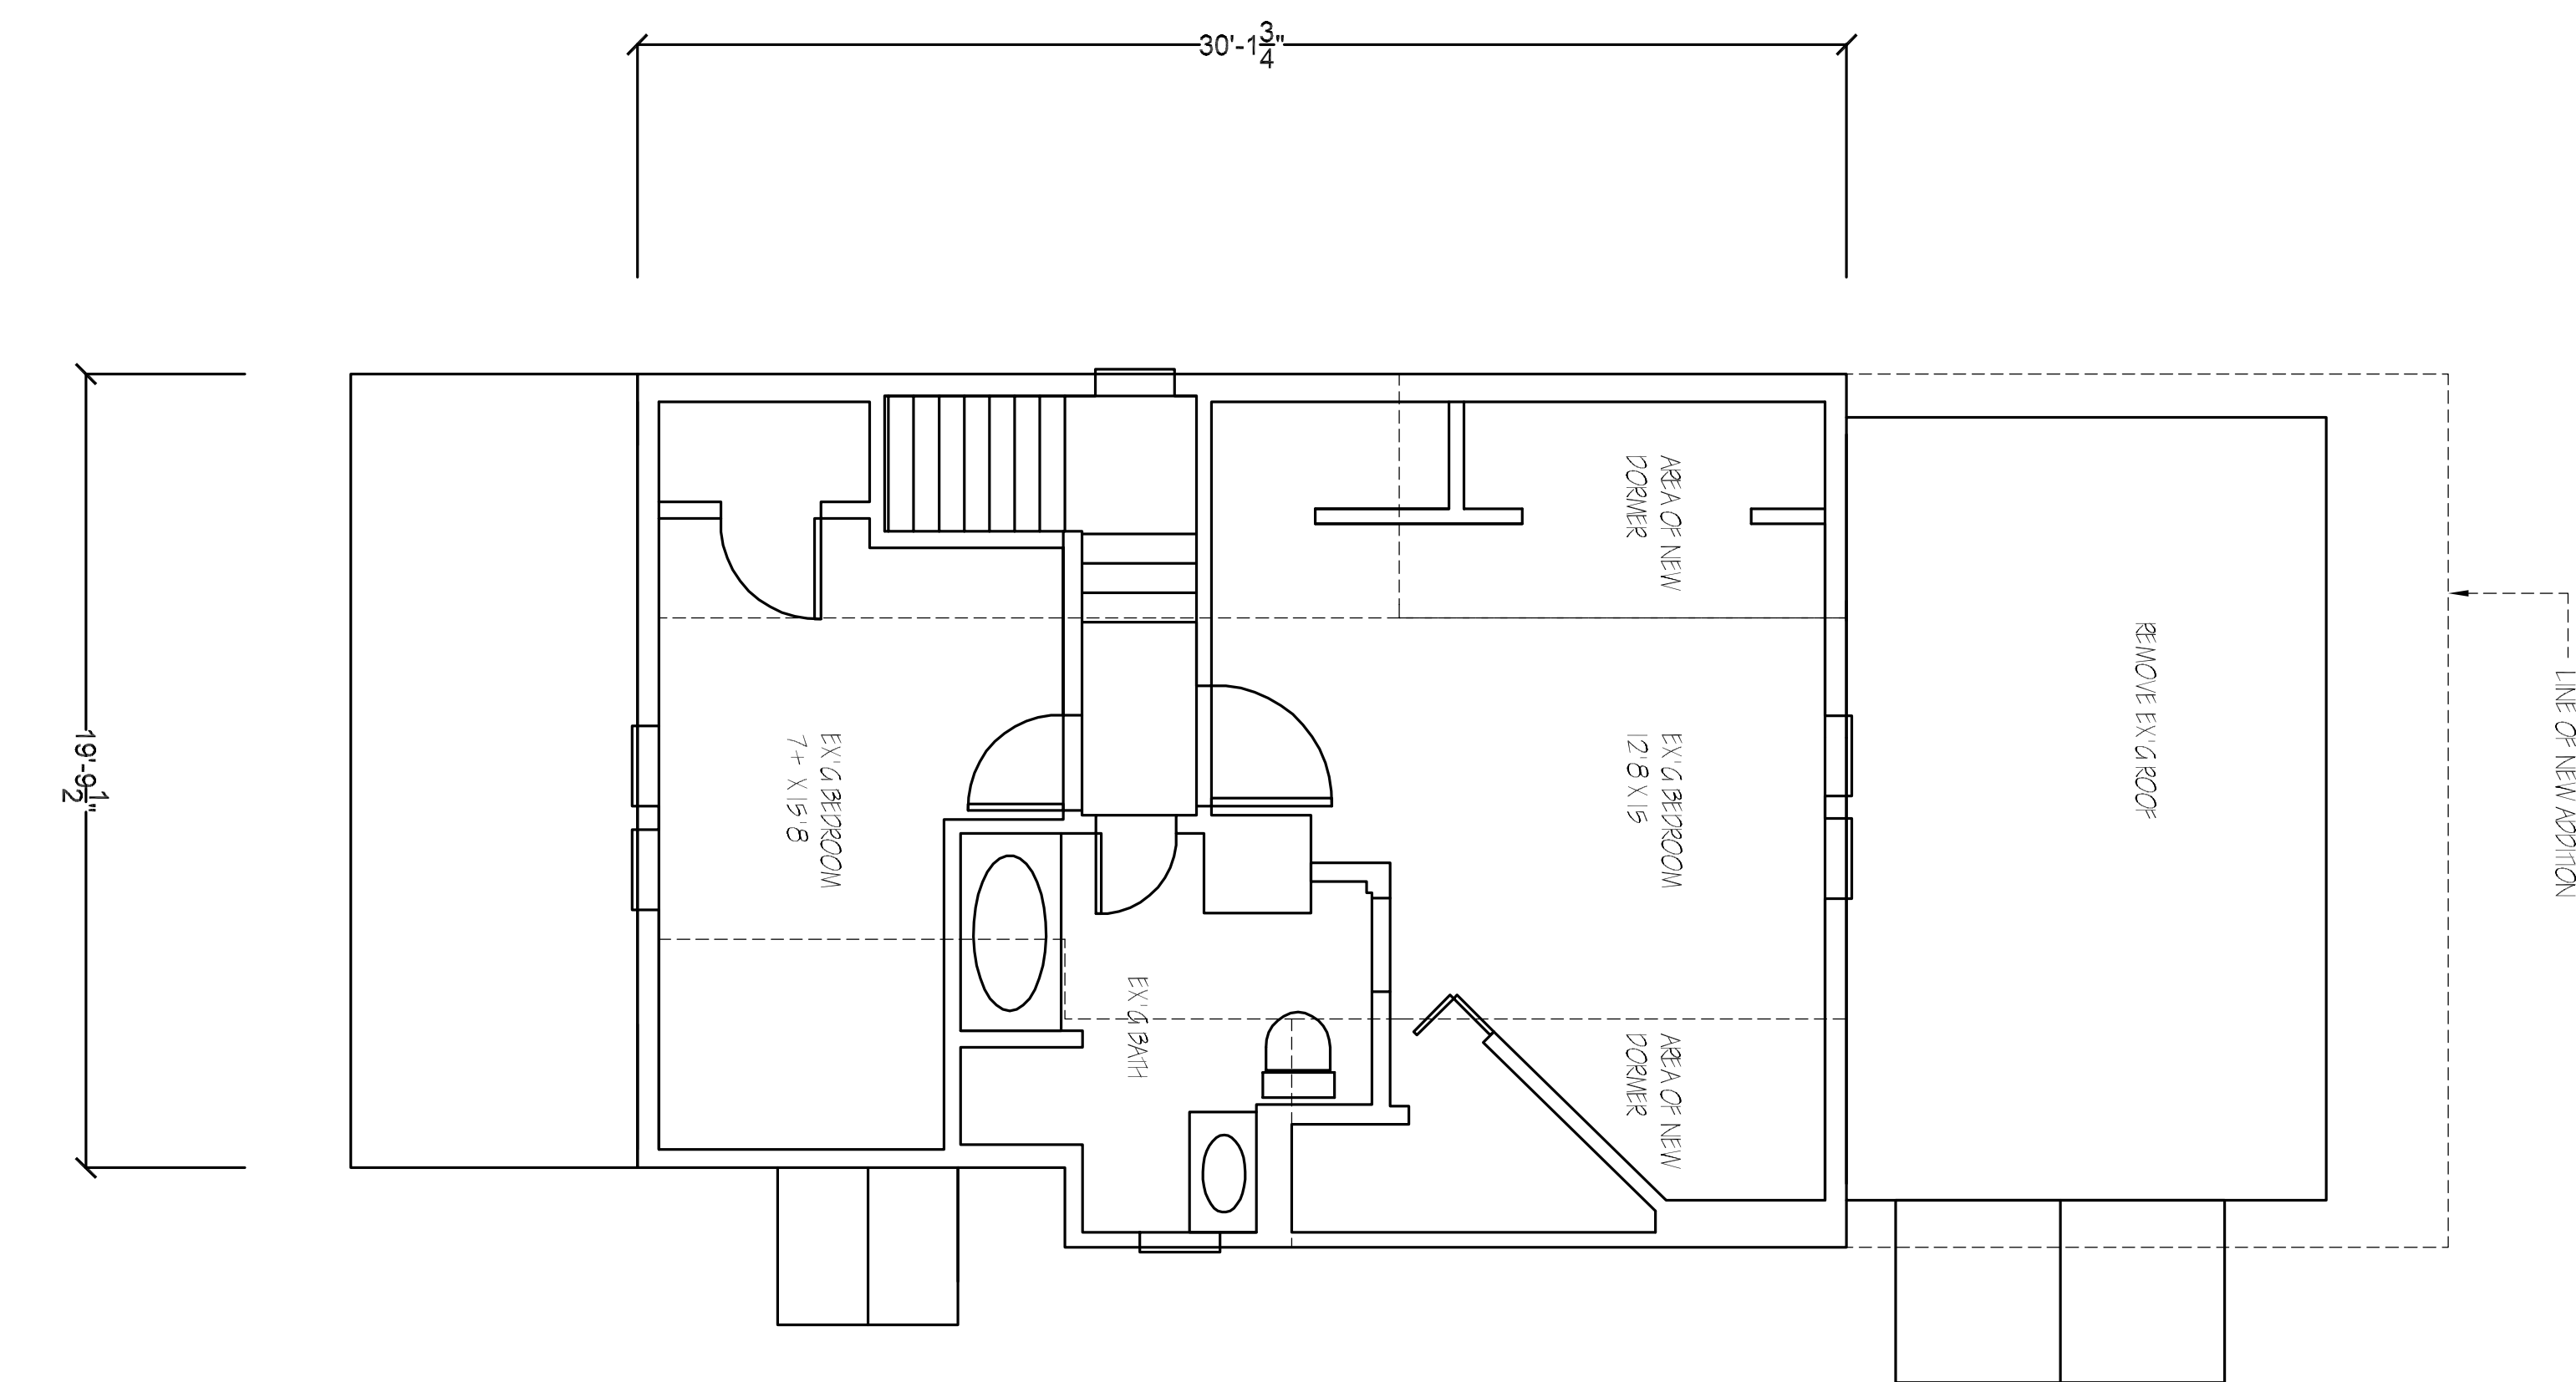

2
5
EXISTING SECOND FLOOR
SCALE 1/4" = 1'-0"

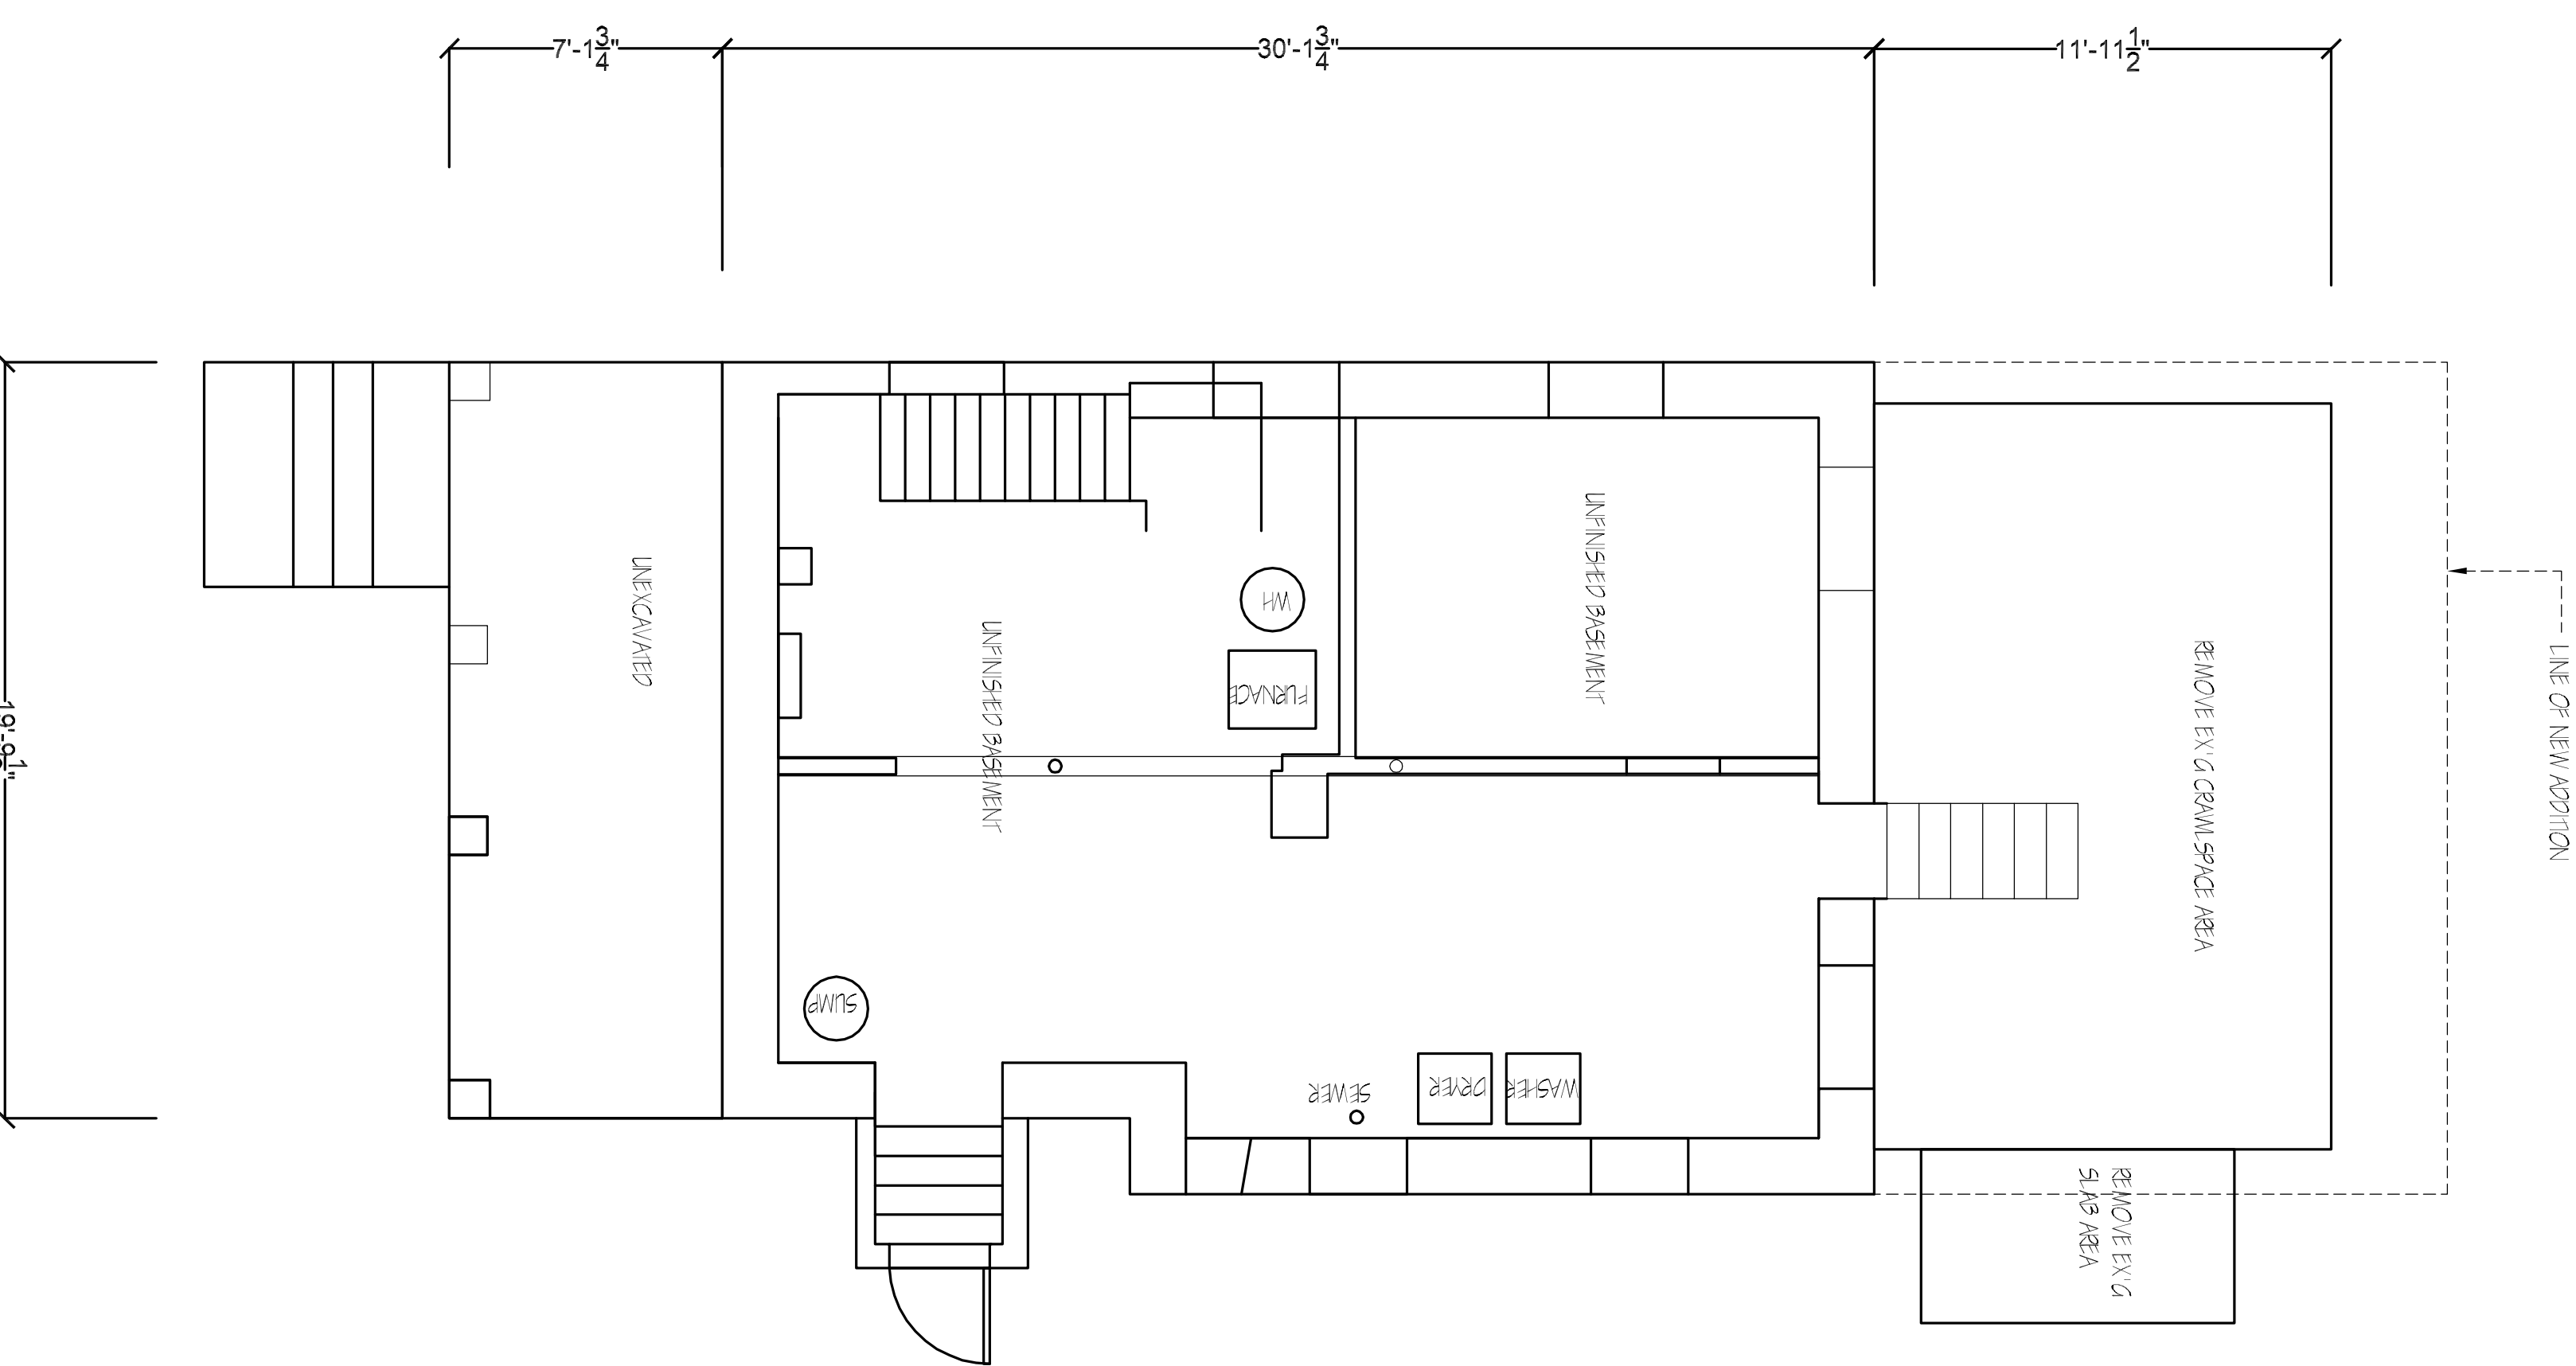


3
5
EXISTING BASEMENT
SCALE 1/4" = 1'-0"

ASBUILT 01-04-21
PROGRESS 01-11-21
PROGRESS 01-21-21
VARIANCE 02-10-21
PROGRESS

PROGRESS
PROGRESS
PROGRESS
BID SET
PERMIT

SHEET 5

ADDITION AND RENOVATION TO THE
RAWLS RESIDENCE
7 MARMON TERRACE
WEST ORANGE, NJ

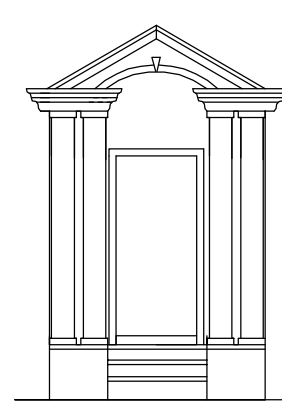

CINDY J. BOERNER-LAY
BOERNER-LAY ARCHITECTS
6 SQUIRE HILL ROAD
LONG VALLEY, NJ 07853
908 - 876 - 9694
NJ LICENSE # 15841