



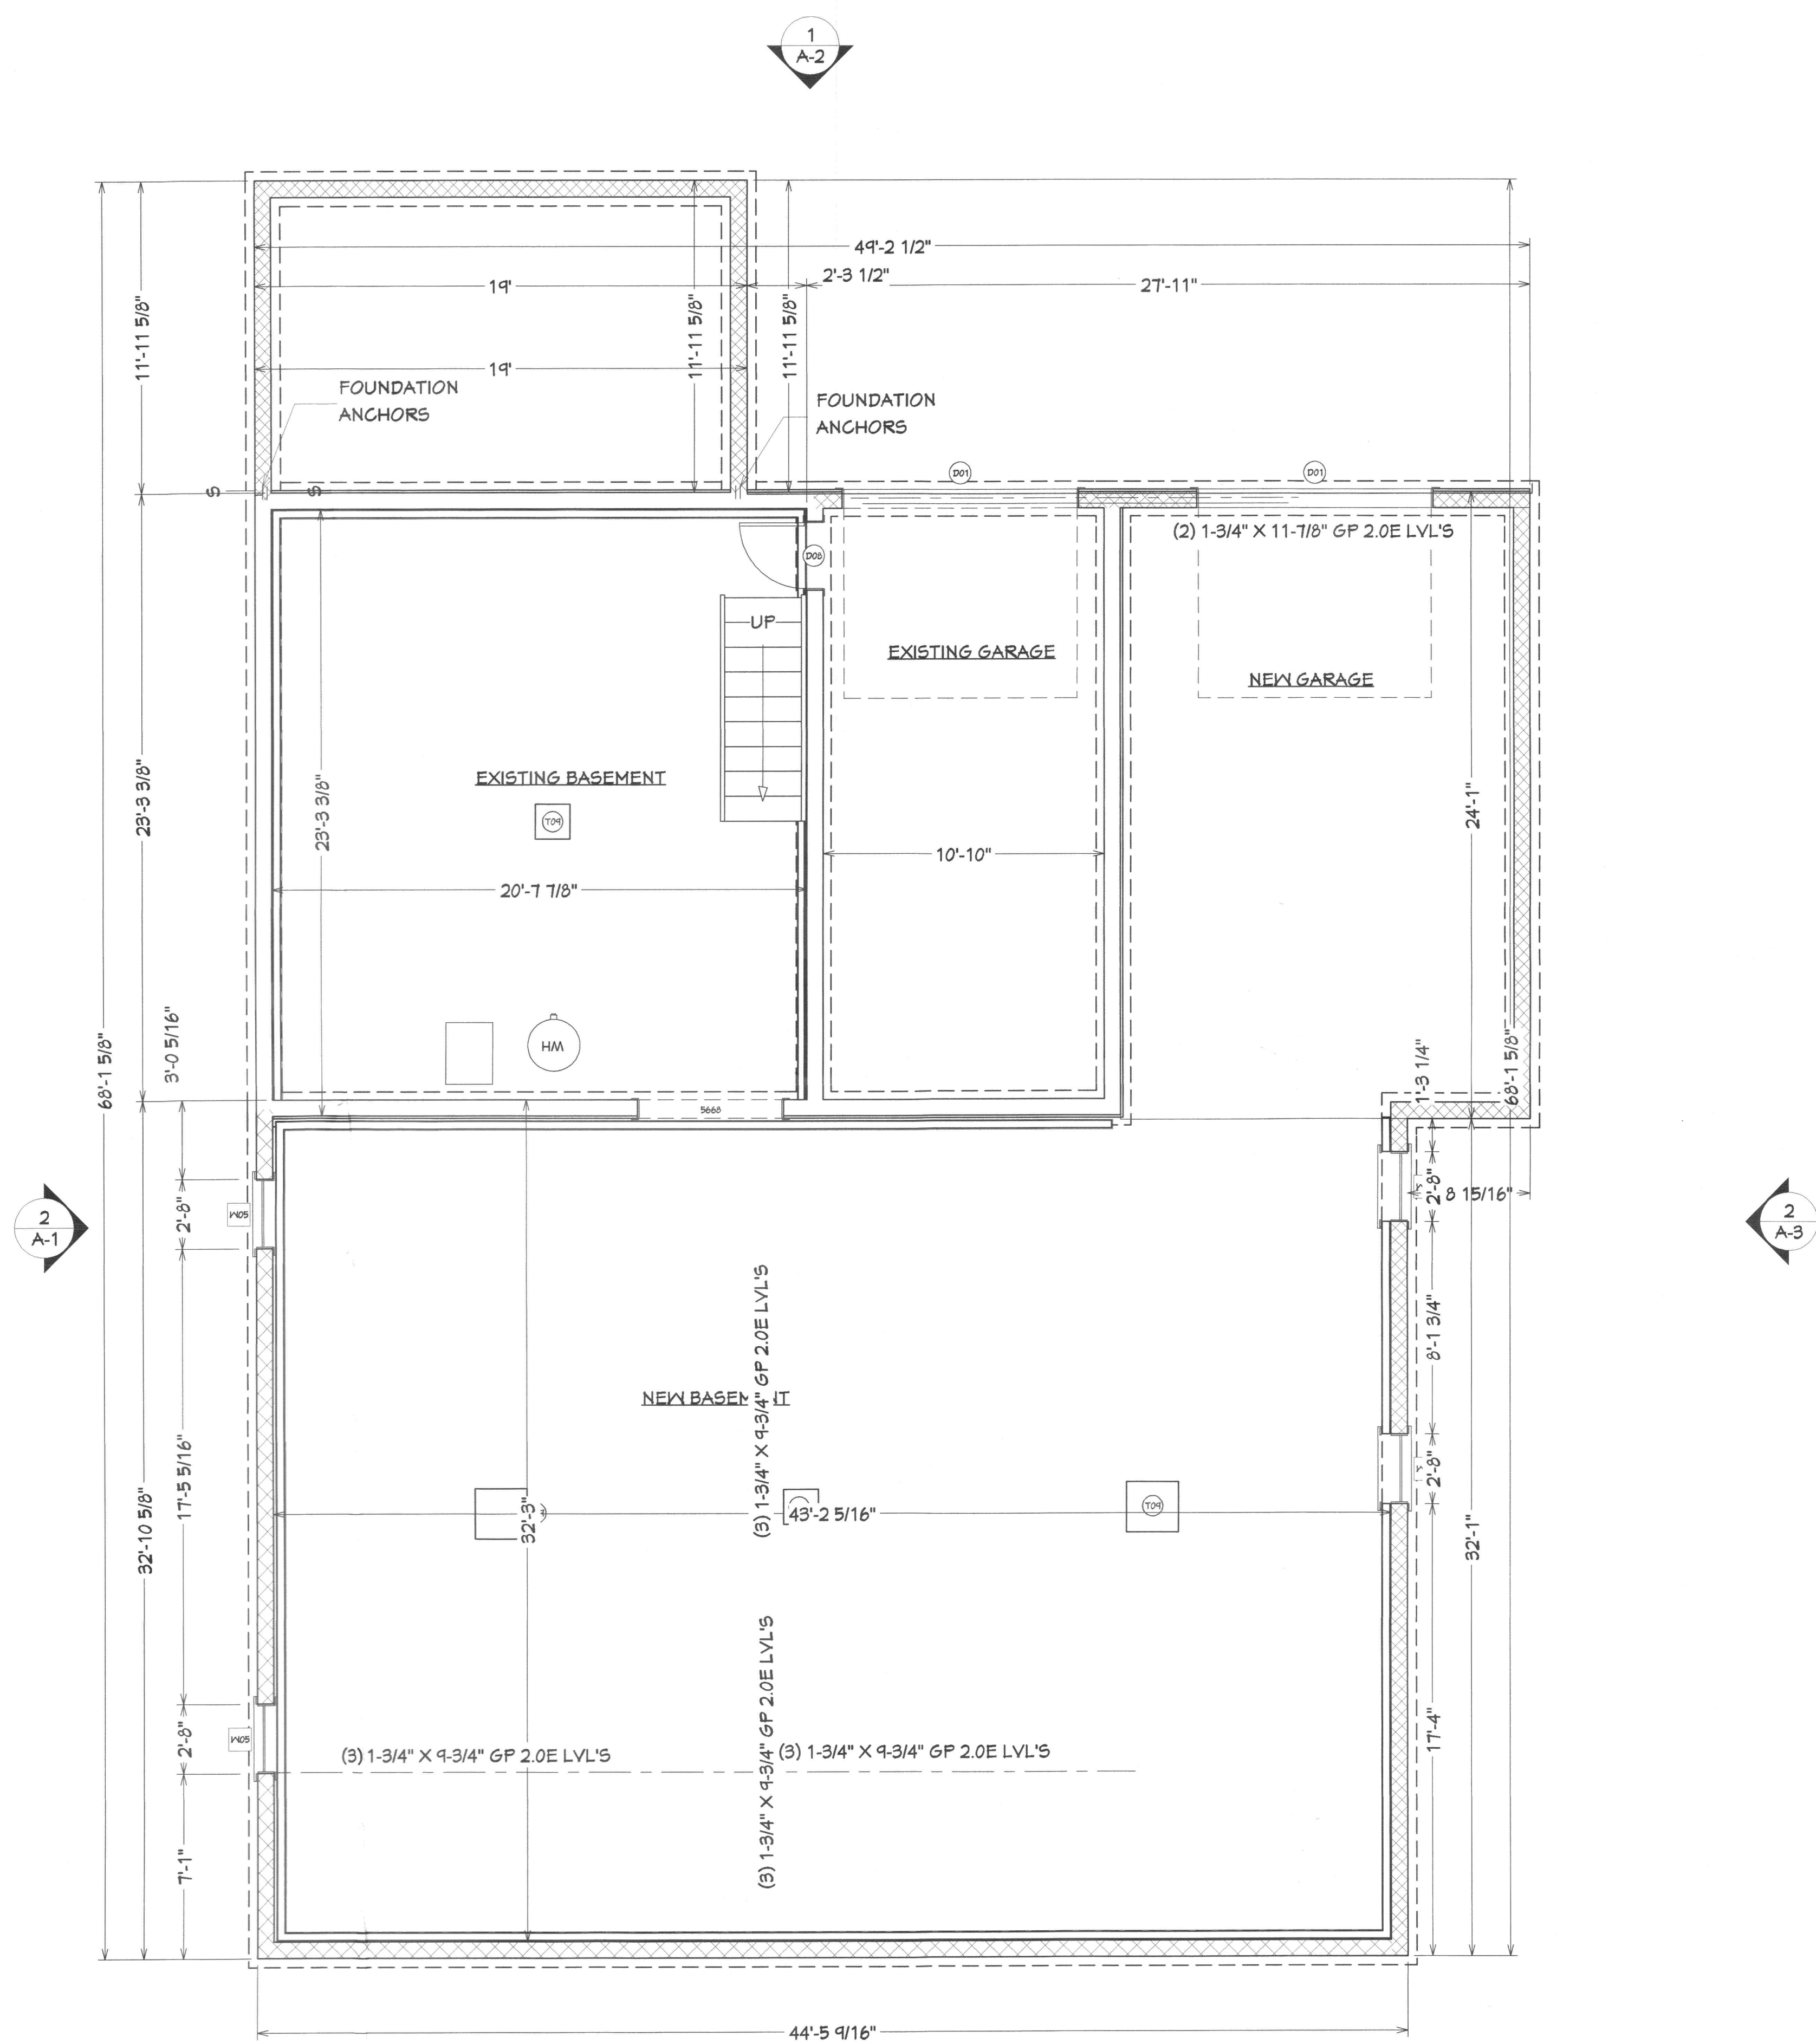

1 BASEMENT AS-BUILT PLAN
SCALE: 1/4" = 1'-0"

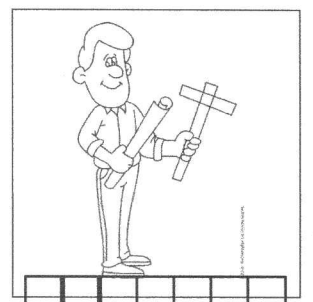

REVISION TABLE	
NUMBER	DATE

PROPOSED ADDITION AND ALTERATIONS
EXISTING RESIDENCE
20 LORELEI ROAD
WEST ORANGE, NJ 07052

BASEMENT AS-BUILT
PLAN & UL DESIGN

DRAWINGS PROVIDED BY:
Christopher O. Dougherty, R.A., LLC
PO box 244
Pompton Lakes, NJ 07442
(201) 674-8432 NJ license 13655

DATE:
1/13/2022
SCALE:
NOTED
SHEET:
A-5