


1 FIRST FLOOR AS-BUILT PLAN
SCALE: 1/4" = 1'-0"

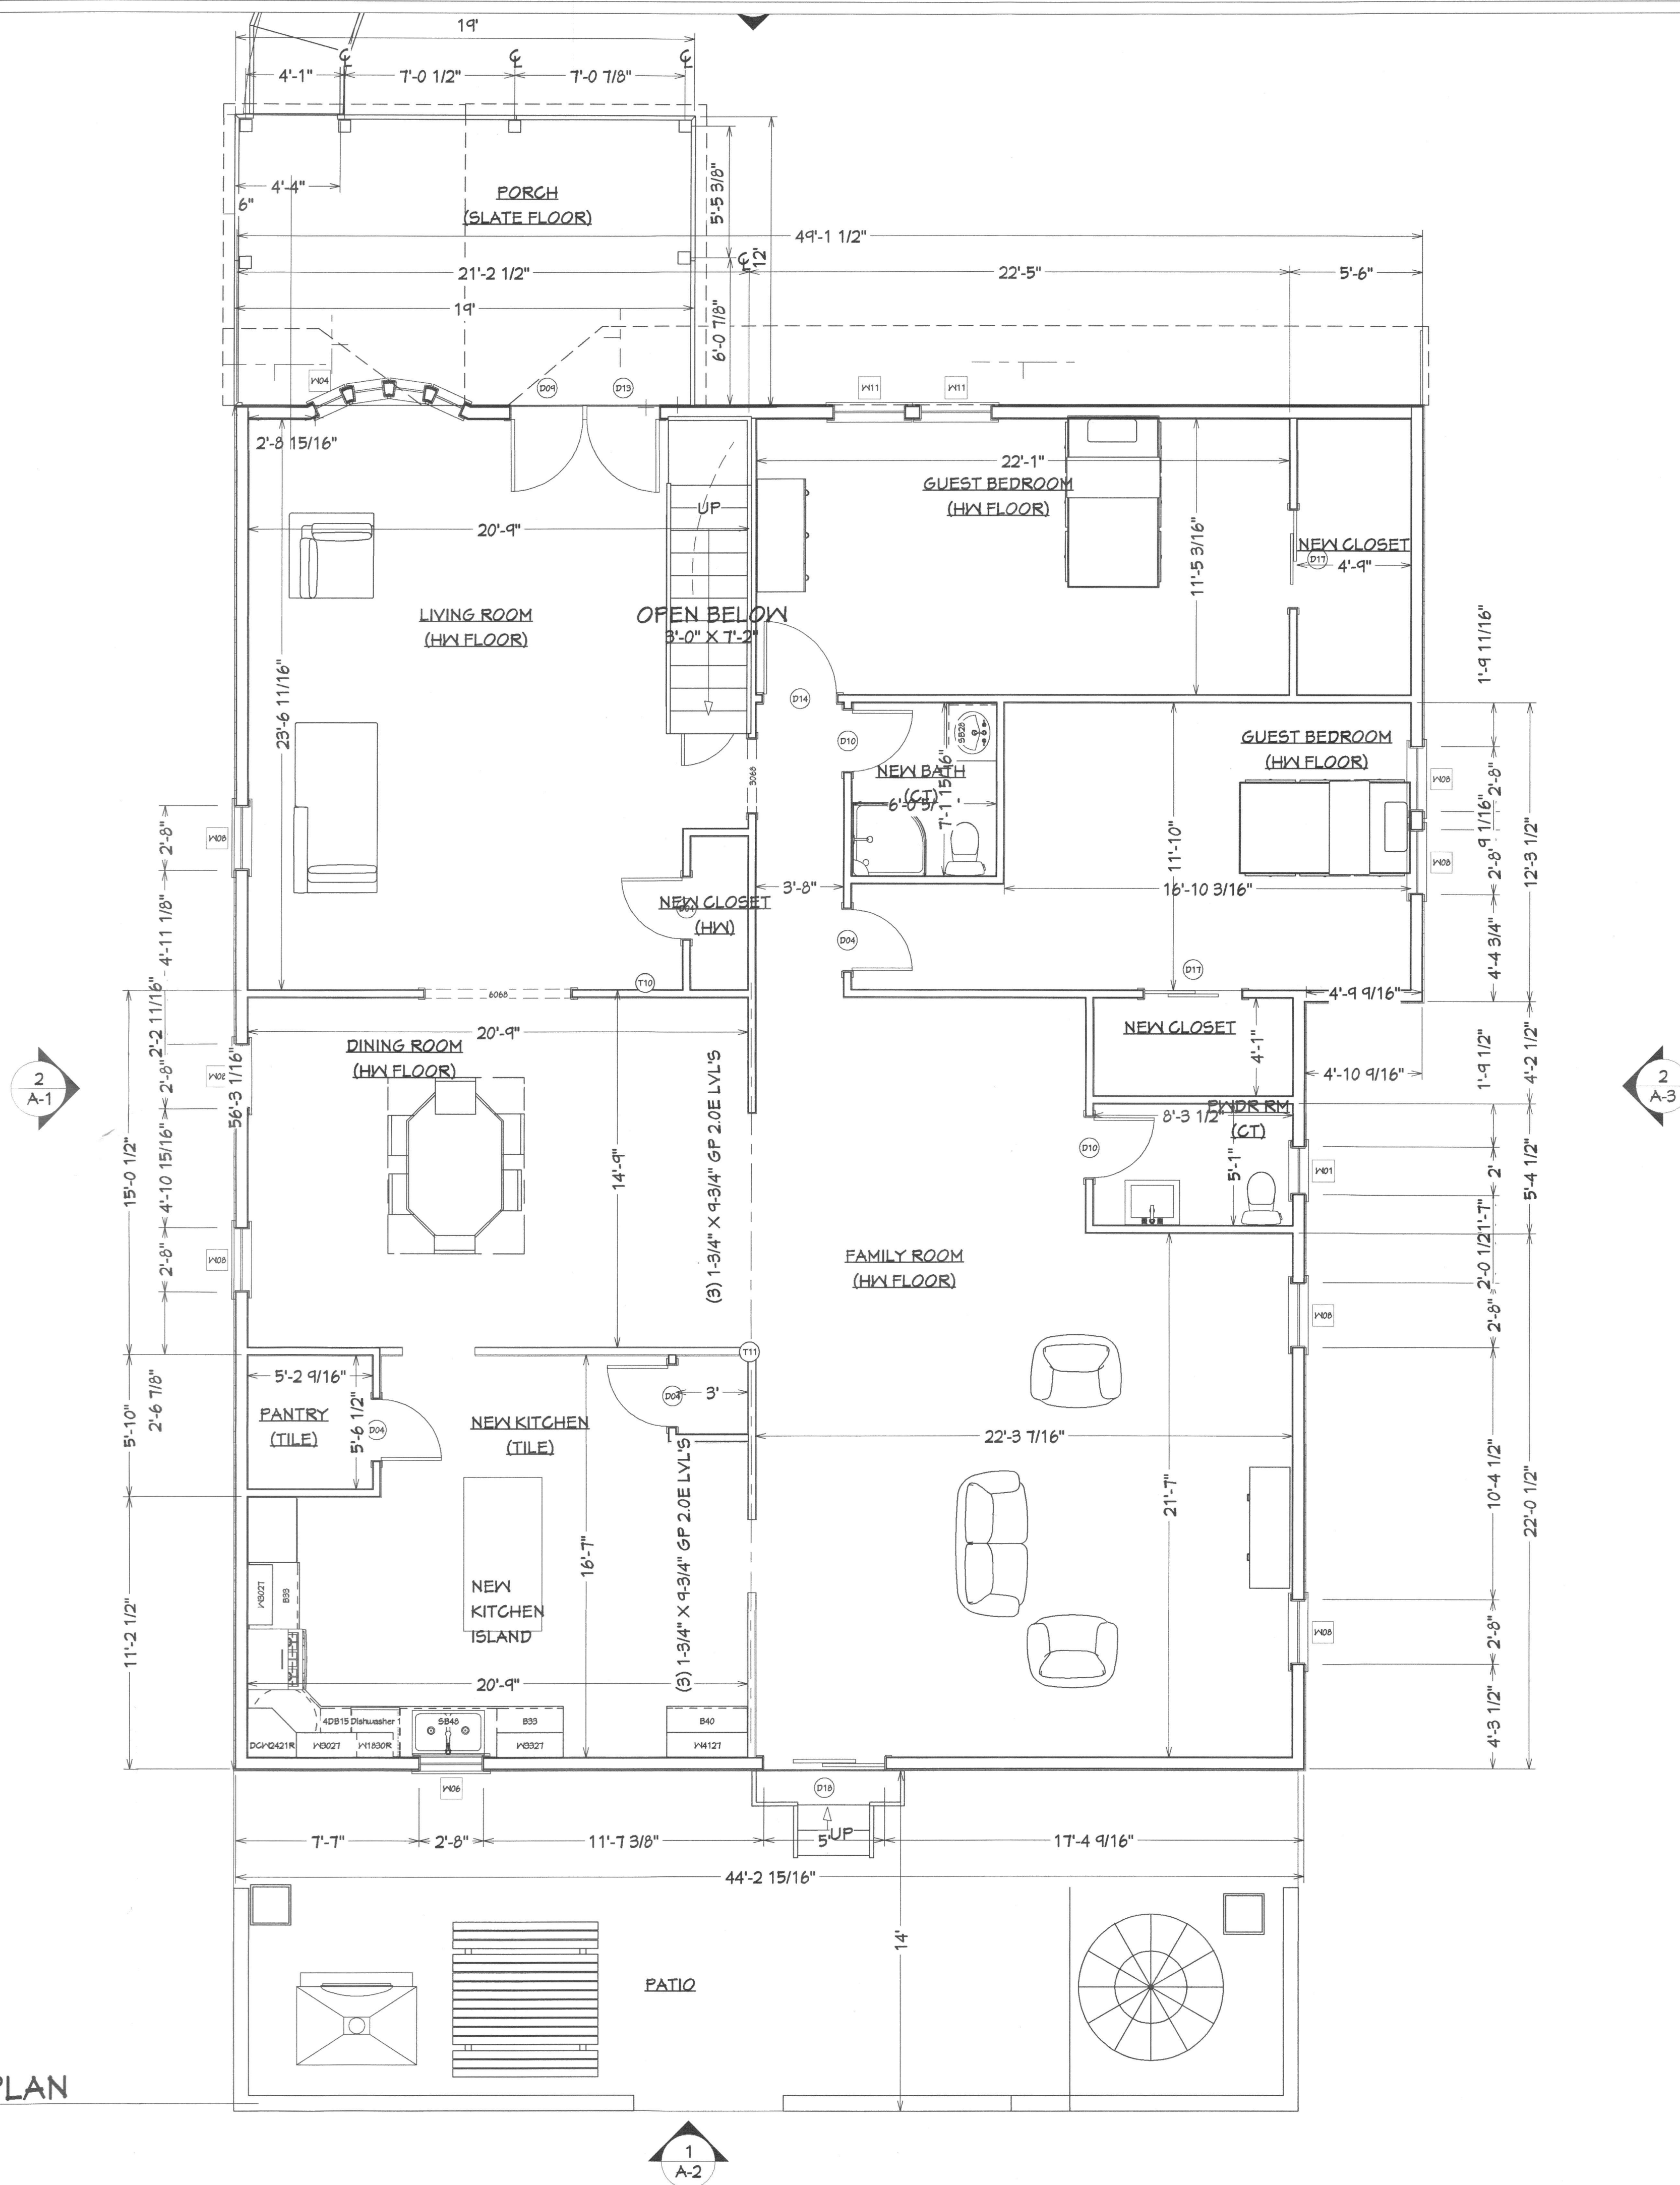

REVISION TABLE	
NUMBER	DATE

PROPOSED ADDITION AND ALTERATIONS
EXISTING RESIDENCE
20 LORELEI ROAD
WEST ORANGE, NJ 07052

FIRST FLOOR AS-BUILT
PLAN

DRAWINGS PROVIDED BY:
Christopher O. Dougherty, RA, AIA, LLC
PO box 244
Pompton Lakes, NJ 07442
(201) 679-8432 NJ license 13053

DATE:
1/13/2022

SCALE:
NOTED

SHEET:
A-3