



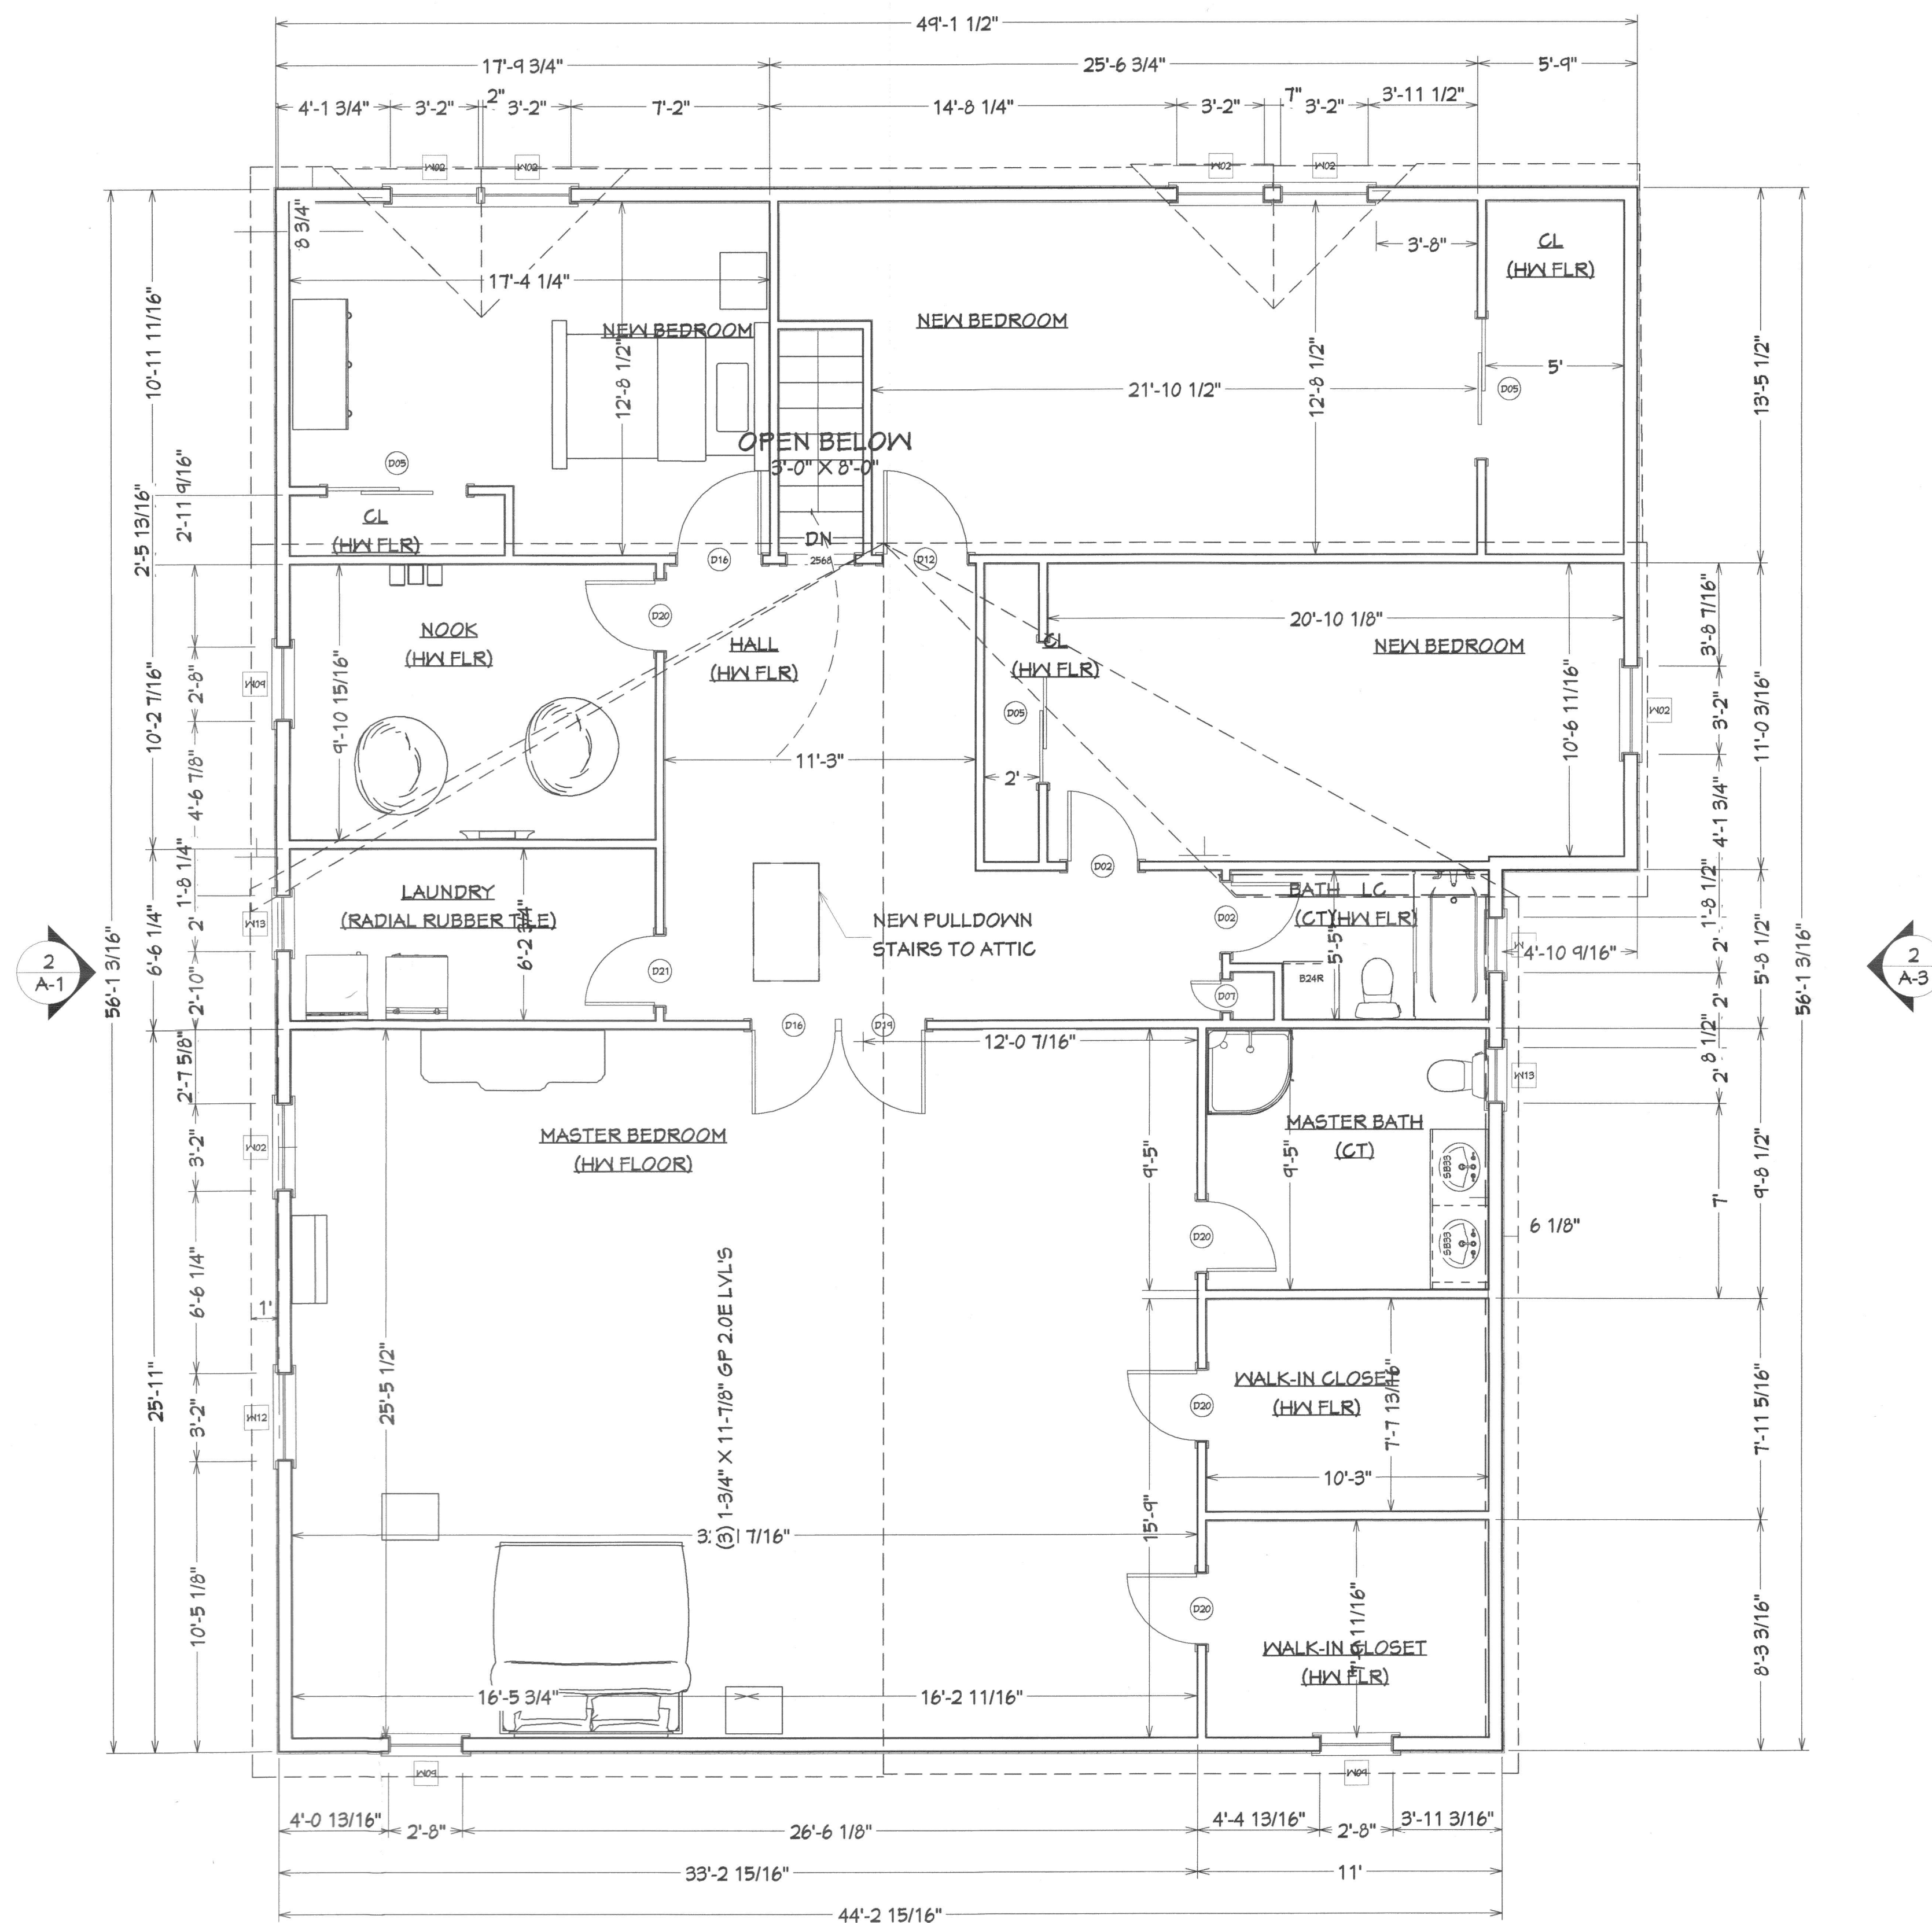

1 SECOND FLOOR PLAN
SCALE: 1/4" = 1'-0"

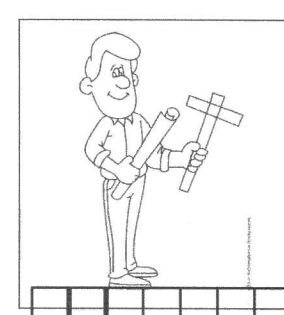

REVISION TABLE	DESCRIPTION
NUMBER	DATE

PROPOSED ADDITION AND ALTERATIONS
EXISTING RESIDENCE
20 LORELEI ROAD
WEST ORANGE, NJ 07052

SECOND FLOOR AS-BUILT PLAN

DRAWINGS PROVIDED BY:
Christopher O. Dougherty, R.A., LLC
PO Box 244
Pompton Lakes, NJ 07442
(201) 679-8482 NJ license 13859

DATE:

1/13/2022

SCALE:

NOTED

SHEET:

A-4